



# MAIN

1st Fl

3/6

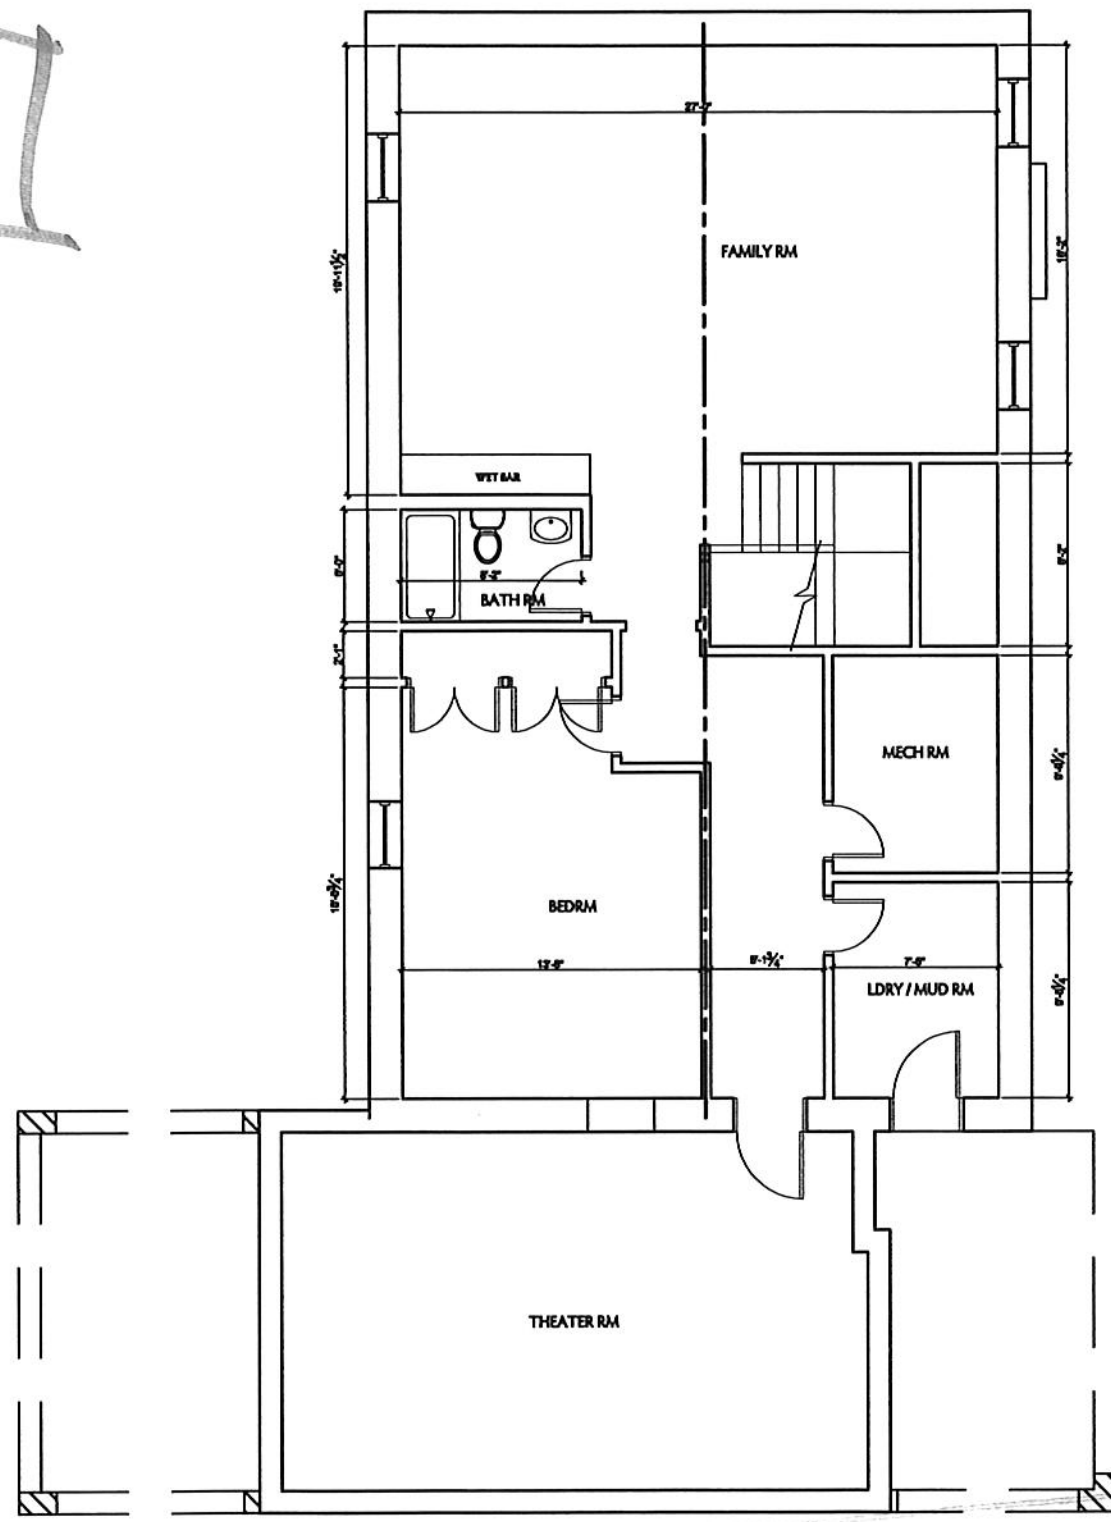

**BASEMENT PLAN: PROPOSED**  
SCALE: 1/4" = 1'-0"

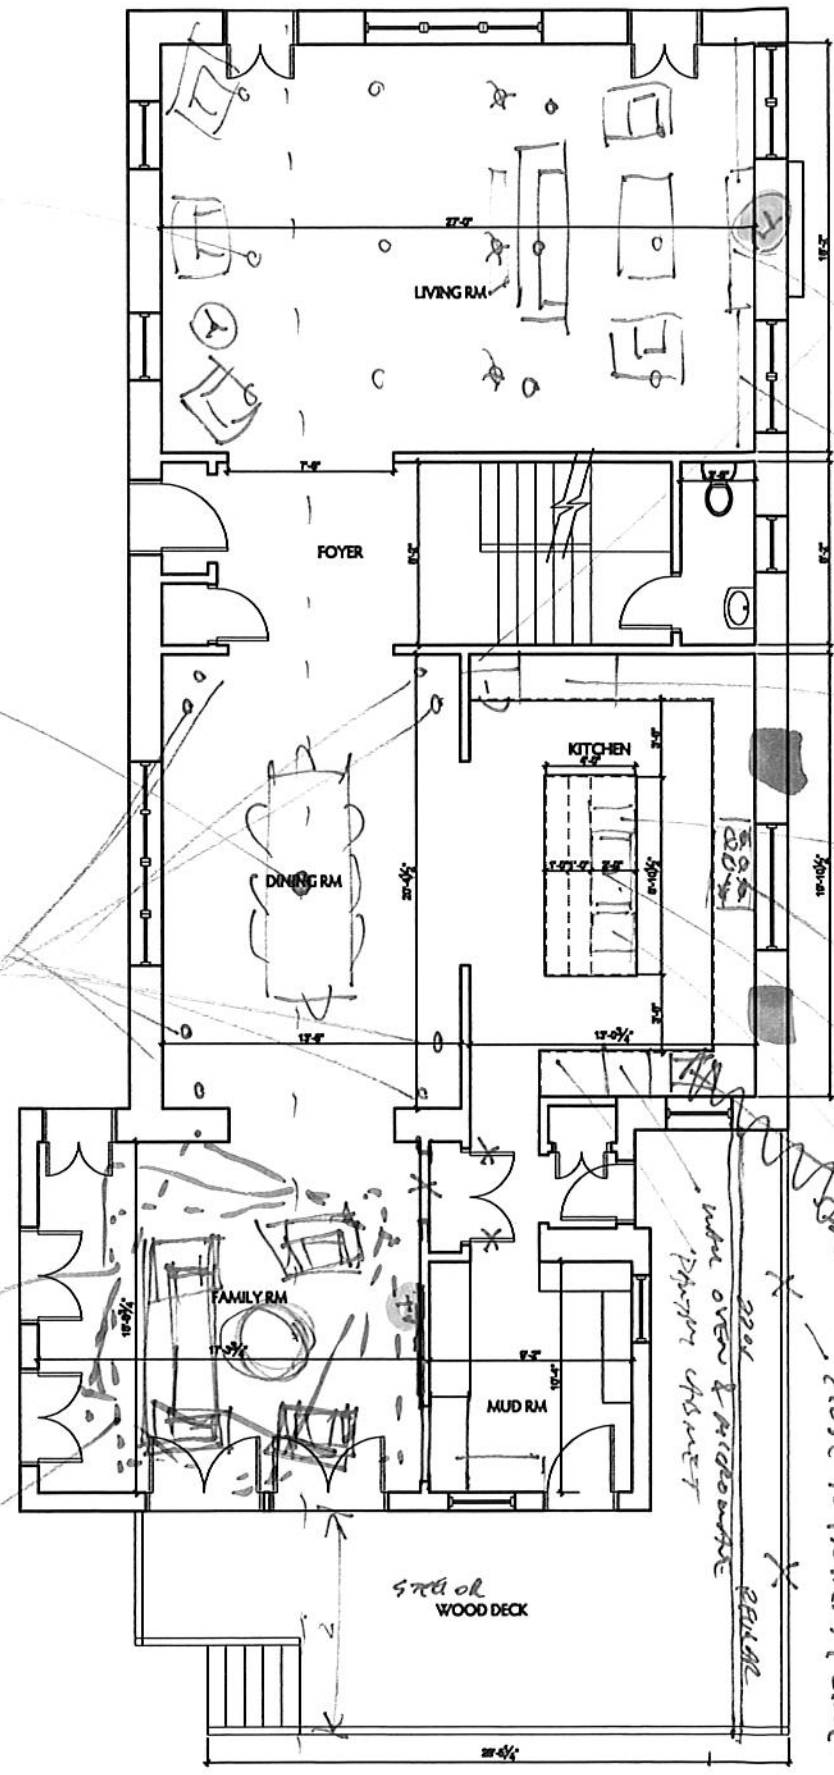

**FIRST FLOOR PLAN: PROPOSED**  
SCALE: 1/16" = 1'-0"

9" caps

CEL BOX

4" caps  
4" caps  
4" caps

Family Rm

PERMIT STATION  
2nd FLOOR


1st FLOOR

48" QUARTZ

48" QUARTZ

WATER SINK


DISPOSABLE

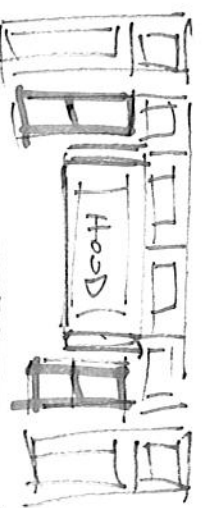

36" x 42" island  
48" island  
220" island 30"


220" OVER & ARCHITECTURE  
220" OVER 30"

5" x 6" or  
WOOD DECK

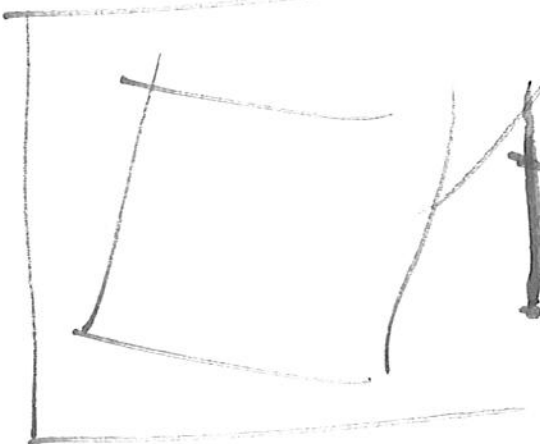


SECOND FLOOR PLAN: PROPOSED

SCALE: 3/16" = 1'-0"

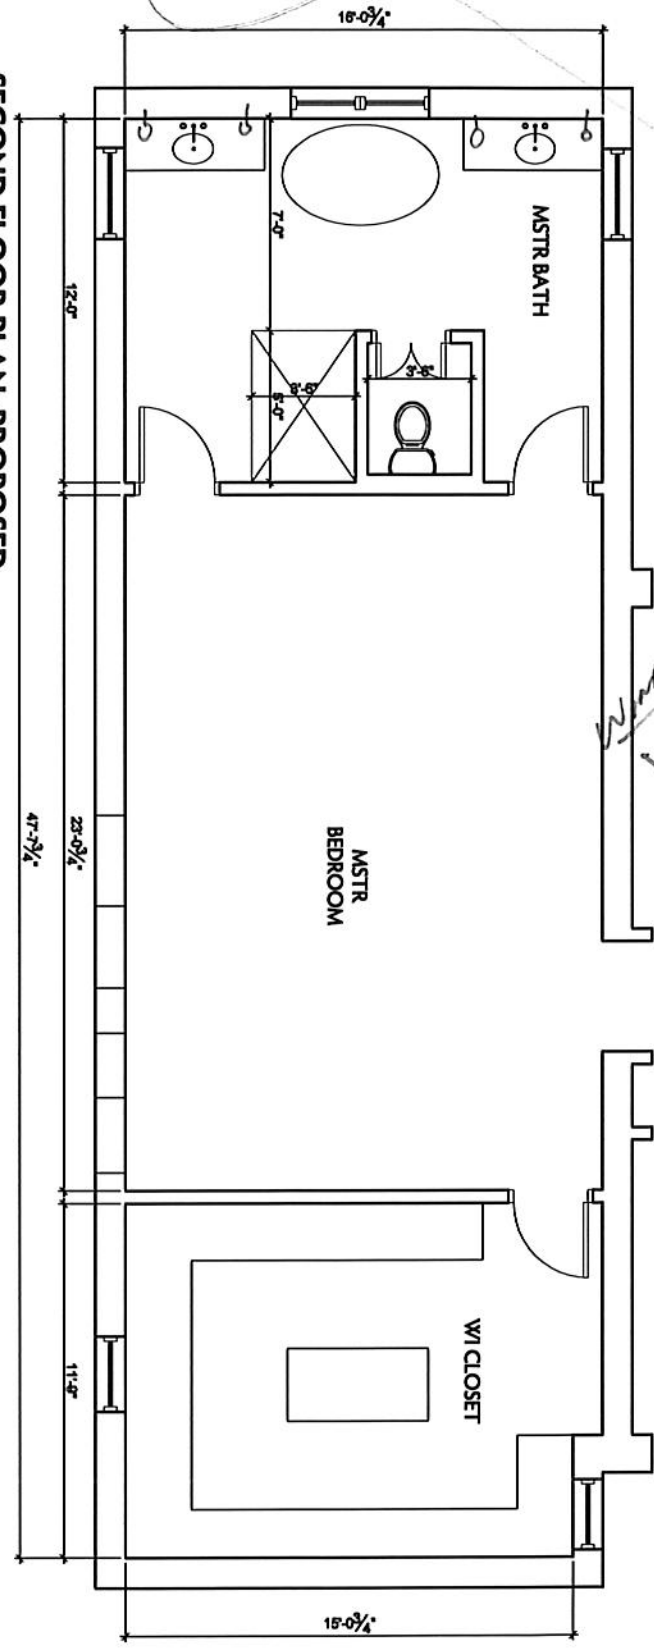

SECOND FLOOR PLAN: PROPOSED

SCALE: 3/16" = 1'-0"

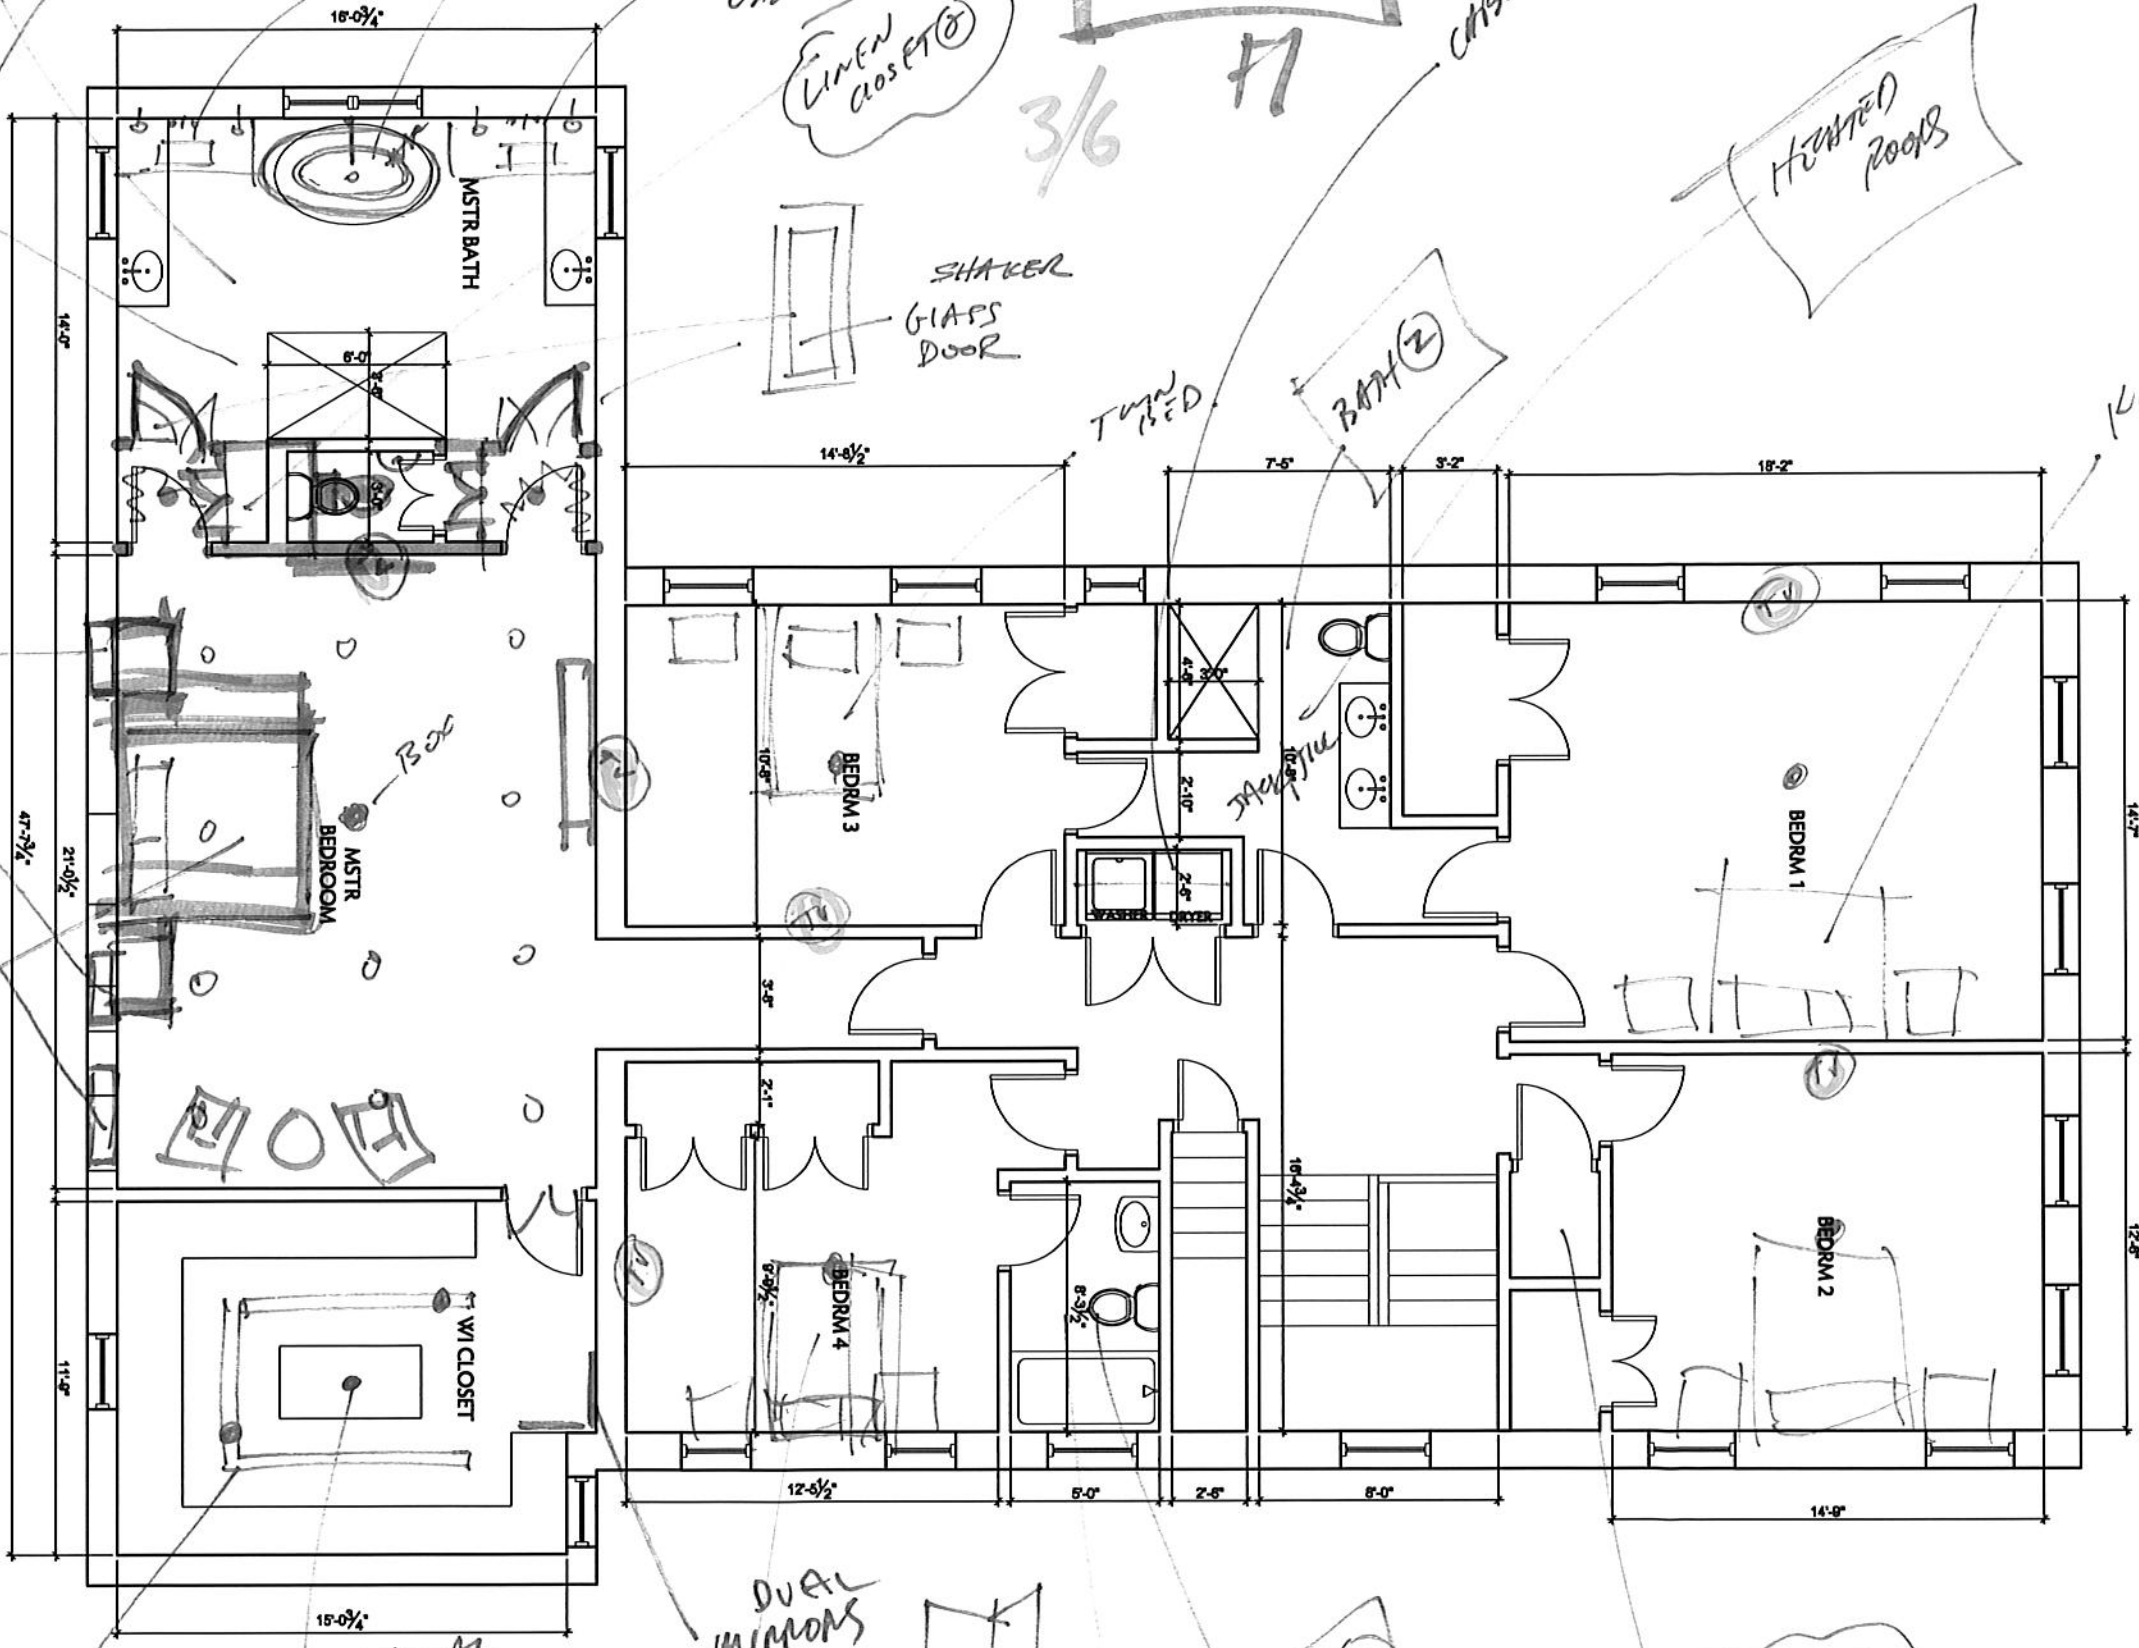

HEATED FLOORS

MSTR BATH W/ SHOWER

67" MIN WATH TUB. "FREE STANDING"

42"-43" JAMB

2ND

CHAPER COMMENTS

HEATED FLOORS

LINEN CLOSET (2)

SHAKER GLASS DOOR

TURN BED

BATH (2)

Kim

Windows

Kim BED

TRUCK LIGHTS

EXTERNAL BOX

DUAL MIRRORS

Over

HEATED FLOORS

BATH (3)

Linen closet (1)




# BASEMENT

3/6

BASEMENT PLAN: PROPOSED

SCALE: 1/4" = 1'-0"

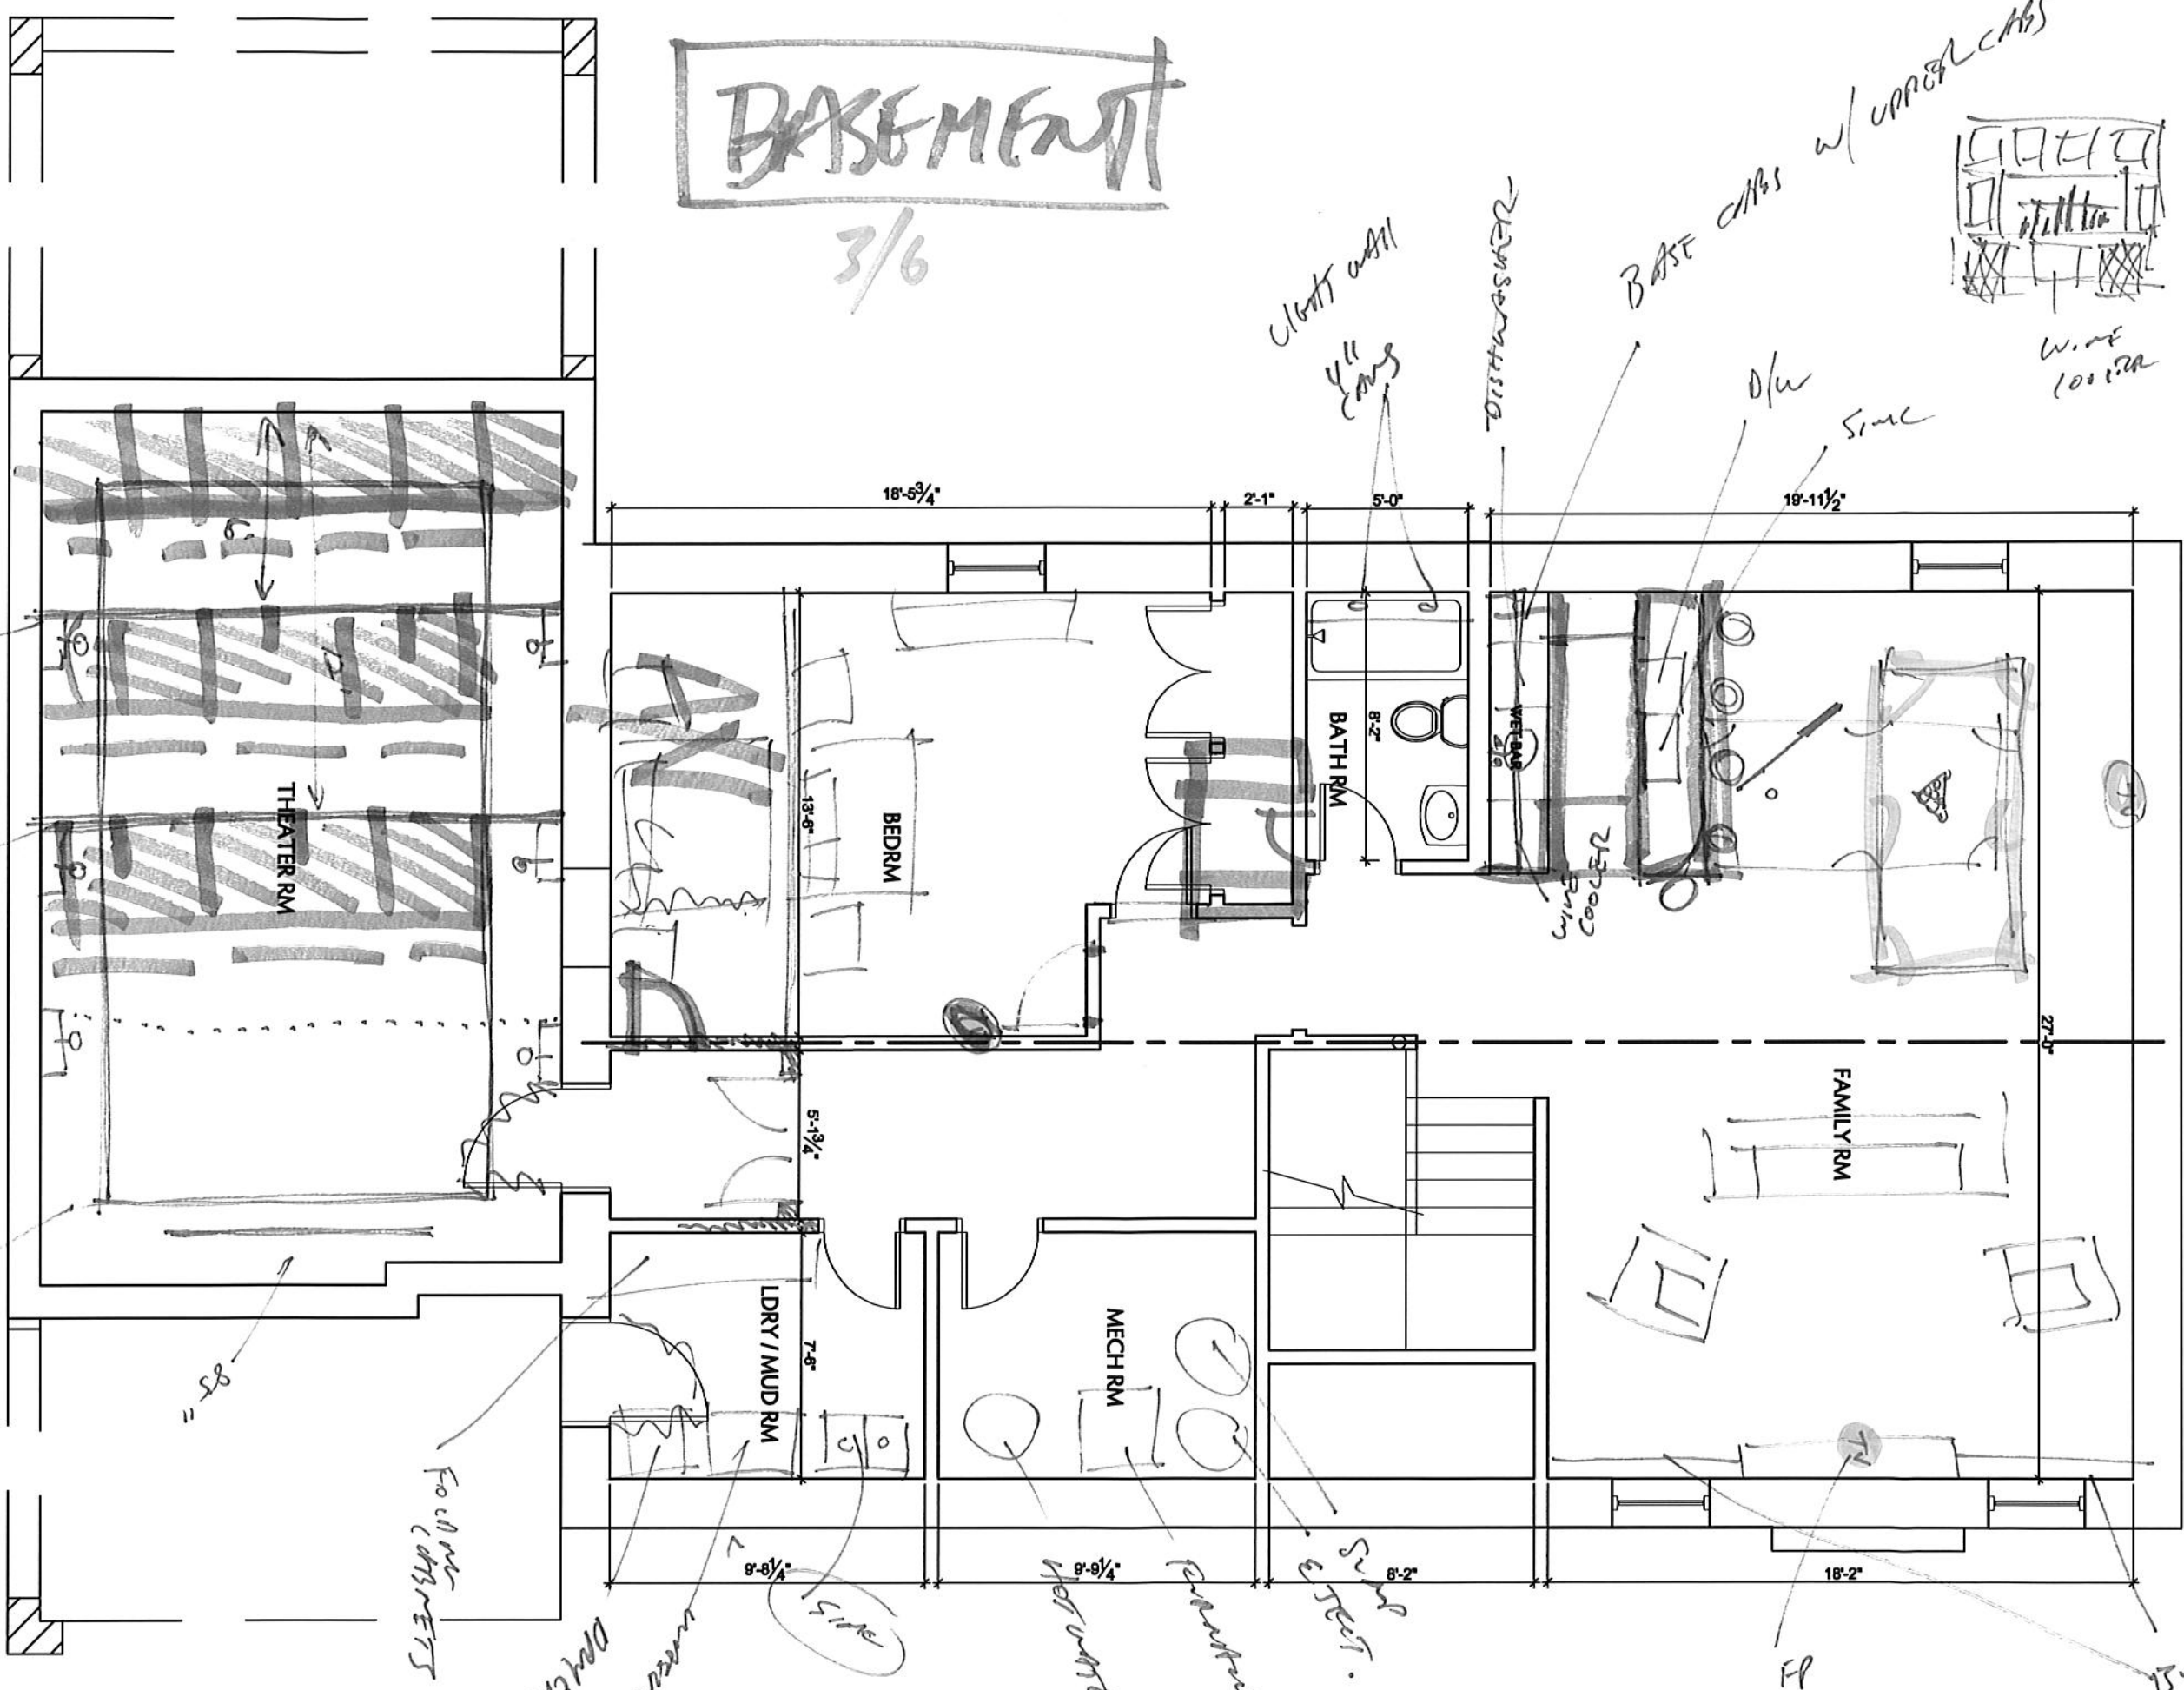

W. of 100' RA

BASE CABS w/ UPPER CABS

CLUBBY CABINETS

DISHWASHER

D/W

SINK

2-37000 COOLING UNIT

FAMILY RM

BEDRM

BATH RM

THEATER RM

LDRY / MUD RM

MECH RM

FOOD CABINETS

WALL

WALL

8'-8 1/4"

9'-9 1/4"

8'-2"

8'-2"

FP



15' x 17' - 10' x 15'

# ATTIC/ROOF

CEILING MOUNTED TV

DIAGRAM  
DRAINAGE

3/6

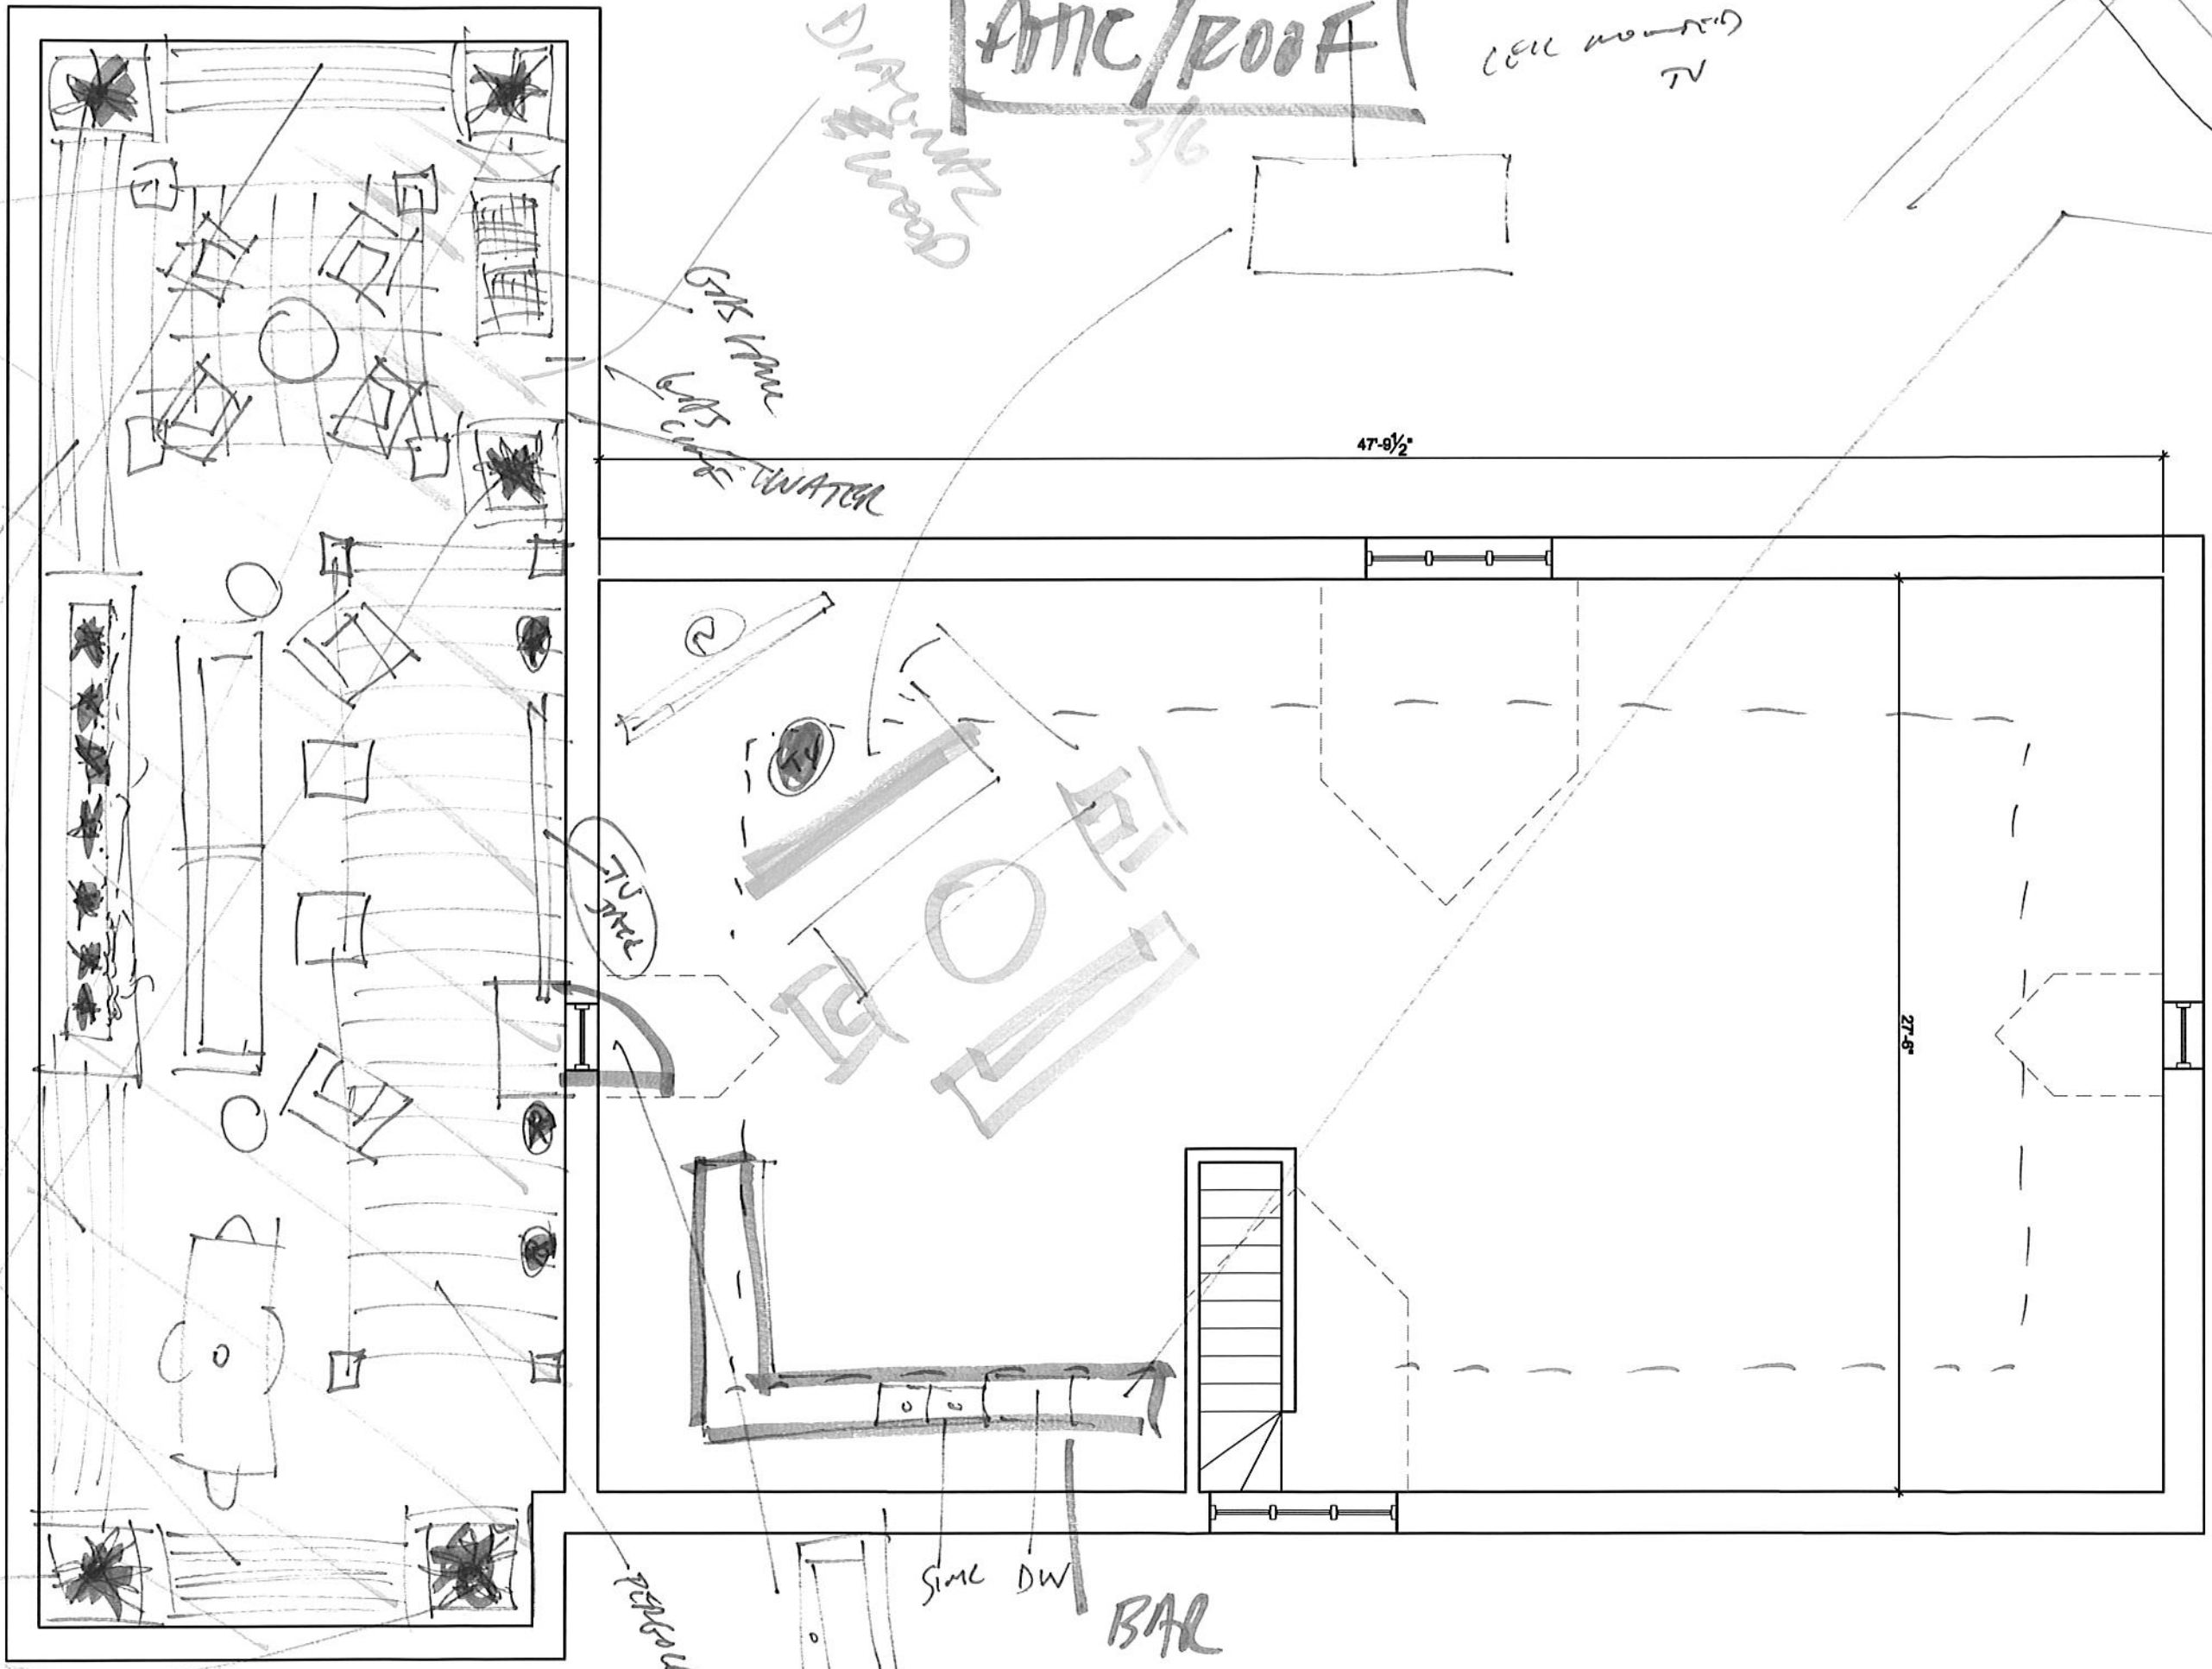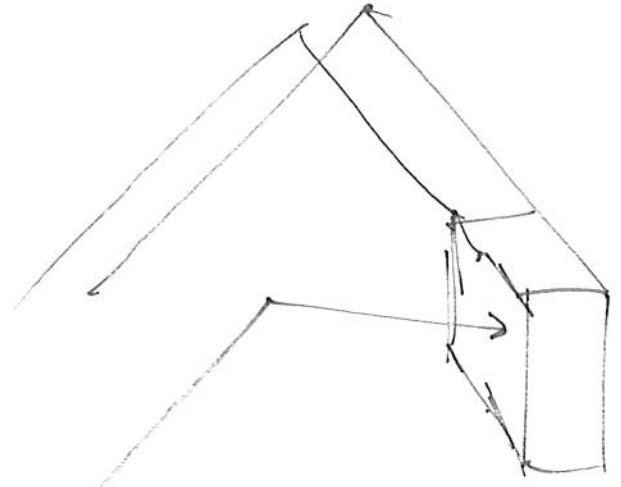

BACK ROOM  
WATER


STAIRS

BAR  
SINGLE DW


PIPERCUA

## ATTIC FLOOR PLAN: EXISTING

SCALE: 3/16" = 1'-0"

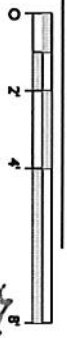

PIPERCUA

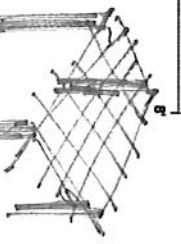

SEATING  
(WOOD)

PIPERCUA  
BOXES